



RAFAT

8850 GEORGE BOLTON PARKWAY, CALEDON, ONTARIO L7E 2Y4

RFI Transmittal No:

Project Name:	Renovation of Chris Gibson Recreation Centre Drive	Project No.	T2023-125
		DATE:	

RFI No:

Title:

To: Patrick Johnson - Contract Administrator (DSA)
Vincent Goetz - Senior Associate (DSA)

Requested by	Rafat	Sketch Attached	<input type="checkbox"/>	Total # Pages	<input type="text"/>
---------------------	-------	------------------------	--------------------------	----------------------	----------------------

Description of RFI	<input type="text"/>				
Response Required By	<input type="text"/>				

Date Responded	<input type="text"/>	Sketch Attached	<input type="checkbox"/>	Total # Pages	<input type="text"/>
-----------------------	----------------------	------------------------	--------------------------	----------------------	----------------------

Consultants Response	<input type="text"/>				
-----------------------------	----------------------	--	--	--	--

Approved/Responded by:

DSA: see Accent Refrigeration comments above and throughout review.
Introba has reviewed this RFI and has no comments.

Patrick Johnson / DSA
April 25, 2025



54 Audia Court, Unit 2
Concord, ON L4K 3N5
(905)-738-1400

Request For Information 23-214-023

Apr 9, 2025

Project Name

CHRIS GIBSON REC CENTRE

Project Address

125 McLaughlin Rd N, Brampton, ON, L6X 1N9

To

Name

Ashish Singla

Company

RAFAT GENERAL CONTRACTOR INC.

Email

asingla@corebuildconstruction.com

Address

8850 GEORGE BOLTON PKWY BOLTON, ON L7E 2Y4

From

Name

MOHAMMED LODHI

Company

Consult Mechanical Inc.

Email

mohammed.l@consultmechanical.com

Address

54 Audia Court, Unit 2 Concord, ON L4K 3N5

Title

Chris Gibson IFC_s Refrigeration drawing.pdf ,
sheet 4 Comments on SD-144R1 DSA page 53 of 59

SCHEDULE IMPACT

Probable

COST IMPACT

Probable

RETURN BY

Apr 16, 2025

Information Requested

Please find attached BAS RFI010 for engineer's review and response, thanks.

Attachments

1. [RFI-010-Mech-Rm140-REF-01-Control.pdf](#)

RFI 010 Request For Information – Ainsworth

To: Paul Leddy
Mohammed Lodhi
Project Manager, Consult Mechanical

Re: **City of Brampton-Chris Gibson Rec Centre - Addition**

Subject: **REF-10 – Sequence of Operations**

Date: Apr 8, 2025

Ref: Chris Gibson IFC M-801,
Chris Gibson IFC_s Refrigeration drawing.pdf , sheet 4
Comments on SD-144R1 DSA page 53 of 59


ACCENT: I think the inlet damper conditions here are correct, but we should probably run at high speed if an ammonia leak is detected. I think the simplest method to provide the ventilation rates required by code would be to run the ventilation fan at low speed all the time (25% speed) and then ramp up to 100% speed if ammonia is detected or if the plant room gets more than 10°C above the outdoor ambient temperature. The outdoor ambient temperature can be read to the BAS through the dehumidifier sensors via BACnet. The BAS would close a relay on the VFD digital inputs to go to high speed in the event the temperature threshold is exceeded.


Description/ Question:

1. Sequence of Operations – REF-01 & REF-02:
Please provide a detailed and finalized revision of the sequence of operations for REF-01 and REF-02. We have identified discrepancies in the follow items 2, 3, and 4. Clarification is required to ensure proper coordination and implementation.
2. IFC mechanical drawing M-801 – Notes 20, 21:
 - Note 20: “Provide high level and low level inlets complete with bird screen and motorized damper at ductwork below fan, to be coordinated on site with location of refrigerant leak.”
 - Note 21: “Fan to be interlocked to refrigerant detection panel. Fan to run at high speed at all times with upper inlet under normal operation. On refrigerant leak detection, upper inlet to close, lower inlet to open, and fan to switch to low speed.”
3. Chris Gibson IFC_s Refrigeration drawing.pdf – sheet 4,
Based on our review, the following components are not within our scope of work. BAS responsibilities are limited to monitoring the related gas alarms via BACnet MS/TP/IP or hardwired connections. Additionally, Ainsworth has not received any datasheets for these devices despite several inquiries:
 - 1 - Ammonia Gas Detector Hung on Wall 10' [3 m] above the Floor Elevation (Tied to Refrigeration Controls and Machinery Room Alarm)
 - 2 - Ammonia Audible Alarm and Warning Light (Tied to Ammonia Gas Detector)
 - 3 - CO2/CO/NOx Gas Detectors with Audible Alarm and Warning Light (Tied to BMS Alarm System and Dehumidifier Process Fan Override)

ACCENT: That is correct. The ammonia gas detector, ammonia alarms/warning lights and the IAQ detectors in the ice arena (for the dehumidifier) are not within Ainsworth's scope of work.

The ammonia items are in CIMCO's scope of work because they are supplying and installing the ammonia detection system. The IAQ sensors in the ice arena would be in Consult Mechanical's scope because they are supplying and installing the dehumidifier

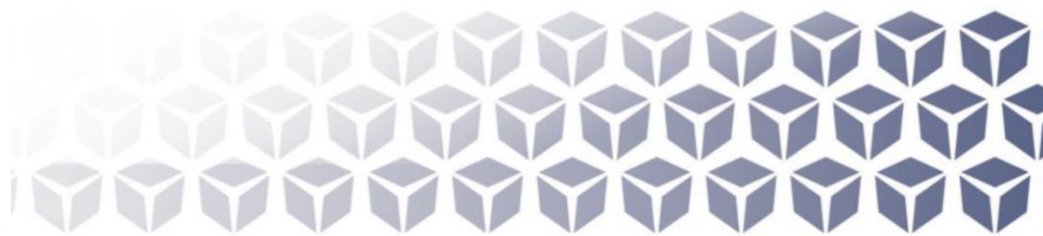

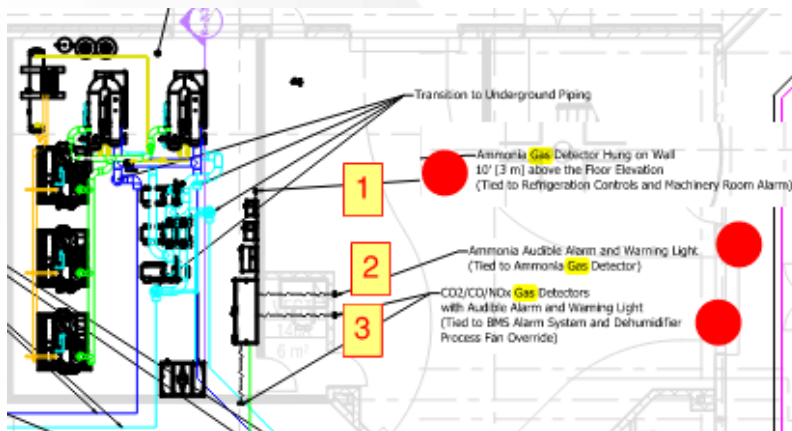

4. SD-144R1 DSA - page 53 of 59:

- Drawing is attached.
- Reviewed comments from Logan Bakker as below,

- Refrigeration gas detection system only monitors airborne ammonia concentration and not any other chemical species.
- Only REF-02 in the Plant room (146B) will have an interlock with the refrigeration gas detection system.

ACCENT:
Correct.

Regards,
Jingli An

Cc:
Noel Santana, Jordan Hoyle

DOOR AIR CURTAIN SCHEDULE

Tag No.	Level	Room No.	Qty.	Model	Max. Door Width (m)	Weight (kg)	ELECTRICAL				NOTES
							Rated Power Input (kW)	Voltage [V]	Phase	Frequency [Hz]	
AC-1	Ground	Vestibule	3	BIDDLE SENSAR SR M-200-E-F	2.032	108	14	230	3	60	1, 2, 3

Notes:

- CW Integral chips control system.
- Free Hung
- Electric door heater

HW BOILER SCHEDULE

MARK	MFR	MODEL	LOCATION	SERVICE	OUTPUT (MBH)	ELECTRIC (kW)	R/W SETTING (PSIG)	VPR	OPER WEIGHT (LBS)	NOTES
EB-1	CLEVER BROTHERS	HW-201	MECHANICAL ROOM	BACKUP	1195	124	81	575560	2591	

- INDOOR TYPE UNIT:**
- PROVIDE MCC CONTROLLER FOR WATER TEMPERATURE ADJUSTMENT.
 - PROVIDE WATER FLOW CONTROL AND SAFETY DEVICES.
 - CONCRETE PAD WITH SPRING SOLUTIONS.
 - NATURAL GAS CONDENSING MODULATING STAINLESS STEEL BOILER.
 - INSTALL WITH STANDARD INTAKE BLENDER AND EXHAUST MAPFLER.
 - CONCRETE PAD WITH SPRING SOLUTIONS.
 - PROVIDE AND INSTALL CONCENTRIC VENT KIT.
 - PROVIDE AND INSTALL CONDENSATE NEUTRALIZATION KIT DRAIN BY PLUMBING.
 - PROVIDE SERIAL VENT AND INTAKE AIR PIPE.
 - XXXXXXXXX CONTROLLER.

FAN SCHEDULE

MARK	MFR	MODEL	LOCATION	SERVICE	CFM	TYPE	FAN			MIN. STATIC	MOTOR		OPER WEIGHT (LBS)	NOTES		
							DA (IN)	HP	BHP		DRIVE	HP			VPR (LBS)	
EP-1A	COOK	EWB-3EWEH6	ARENA ROOF	ARENA	4000	PROPELLER	42	0.5	705	0.677	0.5	VFD	0.75	375560	200	12
EP-1B	COOK	EWB-3EWEH6	ARENA ROOF	ARENA	4000	PROPELLER	42	0.5	705	0.677	0.5	VFD	0.75	375560	200	12
EP-1C	COOK	13520N100T1F	CHILD CARE WASH ROOM	CHILD CARE WASH ROOM	300	NLINE	16	0.5	1303	0.983	0.5	-	0.185	129160	125	16
EP-1D	COOK	13520N100T1F	REF DA	REFEREE ROOM	300	NLINE	16	0.5	1432	0.944	0.5	-	0.185	129160	125	16
EP-1E	COOK	13520N100T1F	LIF WASHROOM	LIF WASHROOM	300	NLINE	16	0.5	1303	0.983	0.5	-	0.185	129160	125	16
EP-1F	COOK	13520N100T1F	LIF WASHROOM	LIF WASHROOM	300	NLINE	16	0.5	1303	0.983	0.5	-	0.185	129160	125	16
EP-1G	COOK	13520N100T1F	LIF WASHROOM	LIF WASHROOM	300	NLINE	16	0.5	1303	0.983	0.5	-	0.185	129160	125	16
EP-1H	COOK	13520N100T1F	ADMIN CHANGEROOM	ADMIN CHANGEROOM	400	NLINE	16	0.5	1476	0.954	0.5	-	0.185	129160	125	16
EP-1I	COOK	QW-189	LIF JANITOR ROOM	LIF JANITOR ROOM	300	NLINE	16	3.25	1228	0.923	0.25	-	0.127	129162	19	3, 4, 5
EP-1J	COOK	QW-189	LIF JANITOR ROOM	LIF JANITOR ROOM	300	NLINE	16	3.25	1228	0.923	0.25	-	0.127	129162	19	3, 4, 5
EP-1K	COOK	ICR14L170R8B	QUART ROOFTOP	QUART ROOM	1800	UPBLAST	-	0.5	1047	1.24	0.5	-	0.250	1100	20, 21	
EP-1L	COOK	ICR14L170R8B	ICE RM MECH ROOF	ICE RM MECH	1800	UPBLAST	-	0.5	1107	1.43	0.5	-	0.250	1100	20, 21	

- PAINTED WHITE EMBEL STEEL GRILLE
- FAN INTERNALLY ISOLATED.
- BACKDRAFT DAMPER INTEGRATED.
- FAN INTERLOCK WITH LIGHTING, POWER AND WIRING BY ELECTRICAL.
- FAN CONTROLLED BY WALL DAMPER SWITCH WITH LIGHT INDICATOR. BROWN MODEL (B/M), (WHITE) OR EQUAL.
- PROVIDE WITH AND CONTROL BY LINE VOLTAGE THERMOSTAT SET TO 5° F.
- FAN INTERLOCK WITH DISMANTLING.
- CONTINUOUS OPERATION DURING OCCUPIED HOURS.
- PROVIDE LAY IN FRAMING FOR OPS/SM INSTALLATION TO ALLOW UNIT ACCESS THROUGH CEILING.
- MOTOR WITH REBUILT COUPLER MOUNT.
- CONTINUOUS OPERATION DURING OCCUPIED HOURS.
- PROVIDE VFD WITH VFD RATED MOTOR.
- 1" INTERNAL ACoustical INSULATION.
- ENERGY STAR RATED FAN.
- REFER TO SPEC. SECTION 19.36 FOR FAN/PURGE EXHAUST FAN REQ'S.
- 16" MIN. R-10 INSULATION WITH LIGHTING, POWER & WIRING BY ELECTRICAL.
- PROVIDE FAN/PURGE EXHAUST SWITCHES AND SENSORS.
- CONNECT TO EMERGENCY POWER.
- CONNECT TO OCC SYSTEM TO OPERATE BASED ON OCCUPANCY SENSOR.
- PROVIDE HIGH LEVEL AND LOW LEVEL. INLETS COMPLETE WITH BAG SCREEN AND MONITORED DAMPER AT DUCTWORK BELOW FAN. TO BE COORDINATED ON SITE WITH LOCATION OF REFRIGERANT LEAK.
- FAN TO BE INTERLOCKED TO REFRIGERANT DETECTION PANEL. FAN TO RUN AT HIGH SPEED WITH UPPER INLET UNDER NORMAL OPERATION ON REFRIGERANT LEAK DETECTION. VFD IN INLET TO CLOSE, LOWER INLET TO OPEN, AND FAN TO SWITCH TO LOW SPEED.

AIR COOLED CONDENSING UNIT SCHEDULE

MARK	MANUFACTURER	MODEL	TYPE	LOCATION	SERVICE	COOLING CAPACITY (MBH)	HEATING CAPACITY (MBH)	SEER	REFRIGERANT	ELECTRICAL			WEIGHT (LBS)	NOTES	
										COMP KW	MCA	MOPC			
CH-1	DAIKIN	R410A1400A	HEAT PUMP	EXISTING CHANGEROOM ROOF	EVAP. & COND.	37	-	18	R410a	3.13	363	20	289160	200	1, 3, 4, 5
CH-2	DAIKIN	R410A1400A	HEAT PUMP	ROOF	EVAP.	13.4	25	R410a	1.5	53	15	289160	200	1, 2, 4, 5, 6	

Notes:

- R410A OR R410A REFRIGERANT ONLY.
- HIGH EFFICIENCY, VARIABLE REFRIGERANT (VRV) UNIT ONLY.
- PROVIDE ALL REQUIRED OPTIONS TO MOUNT ON WALL UNIT TO BE MOUNTED ON WALL 24" ABOVE ROOF LEVEL.
- CONTRACTOR SHALL PROVIDE OPTIONAL BAGNET GATEWAY INTERFACE UNIT TO ALLOW COMMUNICATIONS BETWEEN VRV AND BMS THROUGH BACKET COMMUNICATIONS.
- RATED FOR OUTDOOR CONDITIONS OF 95° DB.
- PROVIDE COMPLETE WITH HEATED DRAIN PAN.

SPLIT SYSTEM FAN COIL UNIT SCHEDULE

MARK	MFR	MODEL	TYPE	LOCATION	SERVICE	FAN			HEATING			DX COOL			ELECTRICAL			OPER WEIGHT (LBS)	NOTES
						CFM	HP (W)	HP (W)	CFM	BTU (W)	BTU (W)	SC (MBH)	TC (MBH)	EAT DB (°F)	LAT DB (°F)	REFRIGERANT	VPR (LBS)		
EP-1	DAIKIN	FV42CP1UJ	WALL HUNG	FOOD	FOOD	290	42	-	0.9	11	86	32	R410a	259160	1.4	125	1.2, 3, 4		
EP-2	DAIKIN	FV42CP1UJ	WALL HUNG	FOOD STORAGE	FOOD STORAGE	290	42	-	0.9	11	86	32	R410a	259160	1.4	125	1, 2, 3, 4		
EP-3	DAIKIN	FV42CP1UJ	WALL HUNG	SOUTHWEST STORAGE	SOUTHWEST STORAGE	290	42	15.3A	0.9	12	86	32	R410a	259160	1.4	125	1, 2, 3, 4		

Notes:

- UNIT SELECTED FOR MIN. DBS AT 91° BELOW DUCTED UNIT.
- R410A OR R410C REFRIGERANT ONLY.
- HIGH EFFICIENCY, MODULATING VRV UNIT.
- TO CONNECT TO CHD1.

STORAGE TANK SCHEDULE

Tag No.	BT-01	BT-02	ST-01	ST-02
Heater Information				
Location	MECH ROOM	MECH ROOM	MECH ROOM	MECH ROOM
Manufacturer	STEELCRAFT	STEELCRAFT	STEELCRAFT	STEELCRAFT
Model	SCDHWT48X096	SCDHWT48X096	SCDHWT78X120	SCDHWT78X120
Type	Storage Tank	Storage Tank	Storage Tank	Storage Tank
Design Information				
Storage Volume	(L) 2405.0	2405.0	6796.0	6796.0
Water Inlet/Outlet Connections NPT	(mm) 50	50	150	150
Height x dia	(mm) 2400 x 1200e	2400 x 1200e	3048 x 1800e	3048 x 1800e
Operating Weight	(kg) 3000.0	3000.0	14000.0	14000.0

Notes:

- Tank Thermostat with 3/4" well
- Relief Valve Kit 1 1/4 inch 120psi
- Provide installation kit

Unit Heaters Schedule

Unit Heater Tag No.	Location	Manufacturer	Model	Airflow (L/s)	Capacity (kW)	FLUID TYPE	E.A.T. (°C)	L.A.T. (°C)	E.W.T. (°C)	L.W.T. (°C)	Flow (L/s)	WPD (ft w.g.)	Dimensions			Electrical Data		Notes
													Width (in)	Height (in)	Depth (in)	Weight (lb)	Voltage	
UH-1	Ice Resurfacer Room	Lennox	UH5B-108	1800	23	35% PG	12.5	24	49	38	0.49	0.36	18	15	8	75	120/160	1, 2, 3
UH-2	Various	Outlet	OAC	151	8	-	-	-	-	-	-	-	32	22	6	50	600/360	1, 4
BBH-1	Multi-Purpose Room	Queltek	ODBA	-	0.4	-	-	-	-	-	-	-	49	6.1	2.5	15	120/160	1, 2, 4

- Notes:**
- Unit heaters to come complete with integrated thermostat
 - Unit heaters to come with standard OSHA fan guard
 - Hydronic Unit Heater
 - Electric Heater

EXPANSION TANK SCHEDULE

MARK	MFR	MODEL	LOCATION	SERVICE	TYPE	SYSTEM VOLUME (GAL)	TANK VOLUME (GAL)	ACCEPTANCE VOLUME (GAL)	MAX. TEMP. (°F)	MIN. TEMP. (°F)	WORKING PRESSURE (PSIG)	MAX. PRESSURE (PSIG)	MIN. PRESSURE (PSIG)	SIZE		SHIP WEIGHT (LBS)	OPER WEIGHT (LBS)	NOTES
														DA (IN)	L IN			
ET-01	BELL & GOSSETT	B-1000	MECHANICAL ROOM	CHWS	HORIZONTAL BLADDER	3000	264	264	70	40	40	80	30	36	76	600	3300	3.5
ET-02	BELL & GOSSETT	B-1000	MECHANICAL ROOM	PHS	HORIZONTAL BLADDER	3000	264	264	100	40	40	80	30	36	76	600	3300	3.5
ET-03	BELL & GOSSETT	P73A-625	MECHANICAL ROOM	DHW	HORIZONTAL BLADDER	4000	132	132	140	40	35	80	25	30	57	400	1900	1.3

- Notes:**
- ASME REPLENISHABLE HEAVY DUTY BUTYL (FOR APPROVED) BLADDER TYPE.
 - FABRICATED STEEL SHELL.
 - PRE-CHARGE PRESSURE SHALL BE EQUAL TO SYSTEM FILL PRESSURE AT TANK LOCATION.
 - CONTRACTOR TO SET PRE-CHARGE PRESSURE.
 - HEAVY DUTY BUTYL RUBBER DAMPHRAM.
 - DAMP-RAM TYPE, CORROSION RESISTENT CONSTRUCTION CONTRACTOR TO SET PRE-CHARGE PRESSURE.

UNLESS NOTED OTHERWISE, ALL DIMENSIONS ARE TO CENTERLINE UNLESS NOTED OTHERWISE. ALL DIMENSIONS ARE TO CENTERLINE UNLESS NOTED OTHERWISE. ALL DIMENSIONS ARE TO CENTERLINE UNLESS NOTED OTHERWISE. ALL DIMENSIONS ARE TO CENTERLINE UNLESS NOTED OTHERWISE.



ISSUED

No.	Date	Description
1	2021-11-01	ISSUED FOR REVIEW
2	2021-11-10	ISSUED FOR 100% CD
3	2022-02-18	ISSUED FOR TENDER
4	2022-06-03	ISSUED FOR BUILDING PERMIT
5	2022-07-20	RESUBMITTED FOR PERMIT
6	2023-03-31	ISSUED FOR TENDER
7	2023-09-08	ISSUED FOR CONSTRUCTION



INTEGRAL
 Toronto Design Studio
 380 Wellington Street West,
 Toronto, ON Canada M5V 1E3
 T +1 416.468.4425
 E: info@integralgroup.com
 www.integralgroup.com

Project North True North

**Chris Gibson Recreation Centre
 Renovation and Addition**

125 McLaughlin Road North
 Brampton, ON
 L6R 1Y7

MECHANICAL EQUIPMENT SCHEDULES

Scale:
 Project No: 210305
 Date: 2022-04-06



DESIGN STANDARDS

CSA B5218 MECHANICAL REFRIGERATION
CODE

CSA B519 BOILER AND PRESSURE
VESSEL CODE

CANADIAN ELECTRICAL CODE

ASME B31.5 REFRIGERATION PIPING AND
HEAT TRANSFER COMPONENTS

DRAWN BY
L. BAKKER

DATE
01/06/2021

APPROVED BY
A. SUTHERLAND

DATE
08/06/2021

PROJECT TITLE

Chris Gibson
Recreation
Centre


SHEET TITLE

Ice Rink
Refrigeration
System Plan
View

REVISIONS


REV #	DATE	DESCRIPTION
R1	17/06/2021	ISSUED FOR 50 PERCENT CONSTRUCTION DOCUMENTS
R2	24/09/2021	ISSUED FOR 90 PERCENT CONSTRUCTION DOCUMENTS
R3	10/11/2021	ISSUED FOR 100 PERCENT CONSTRUCTION DOCUMENTS
R4	18/02/2022	ISSUED FOR TENDER
R5	03/06/2022	ISSUED FOR BUILDING PERMIT
R6	03/06/2022	ADDED DETAIL FOR ZAMBONI GATE
R7	31/03/2023	RE-ISSUED FOR TENDER
R8	08/09/2023	ISSUED FOR CONSTRUCTION
R9	-	-

SHEET SIZE	DRAWING #	DRAWING REV #	SHEET #
D	R-20	R8	4

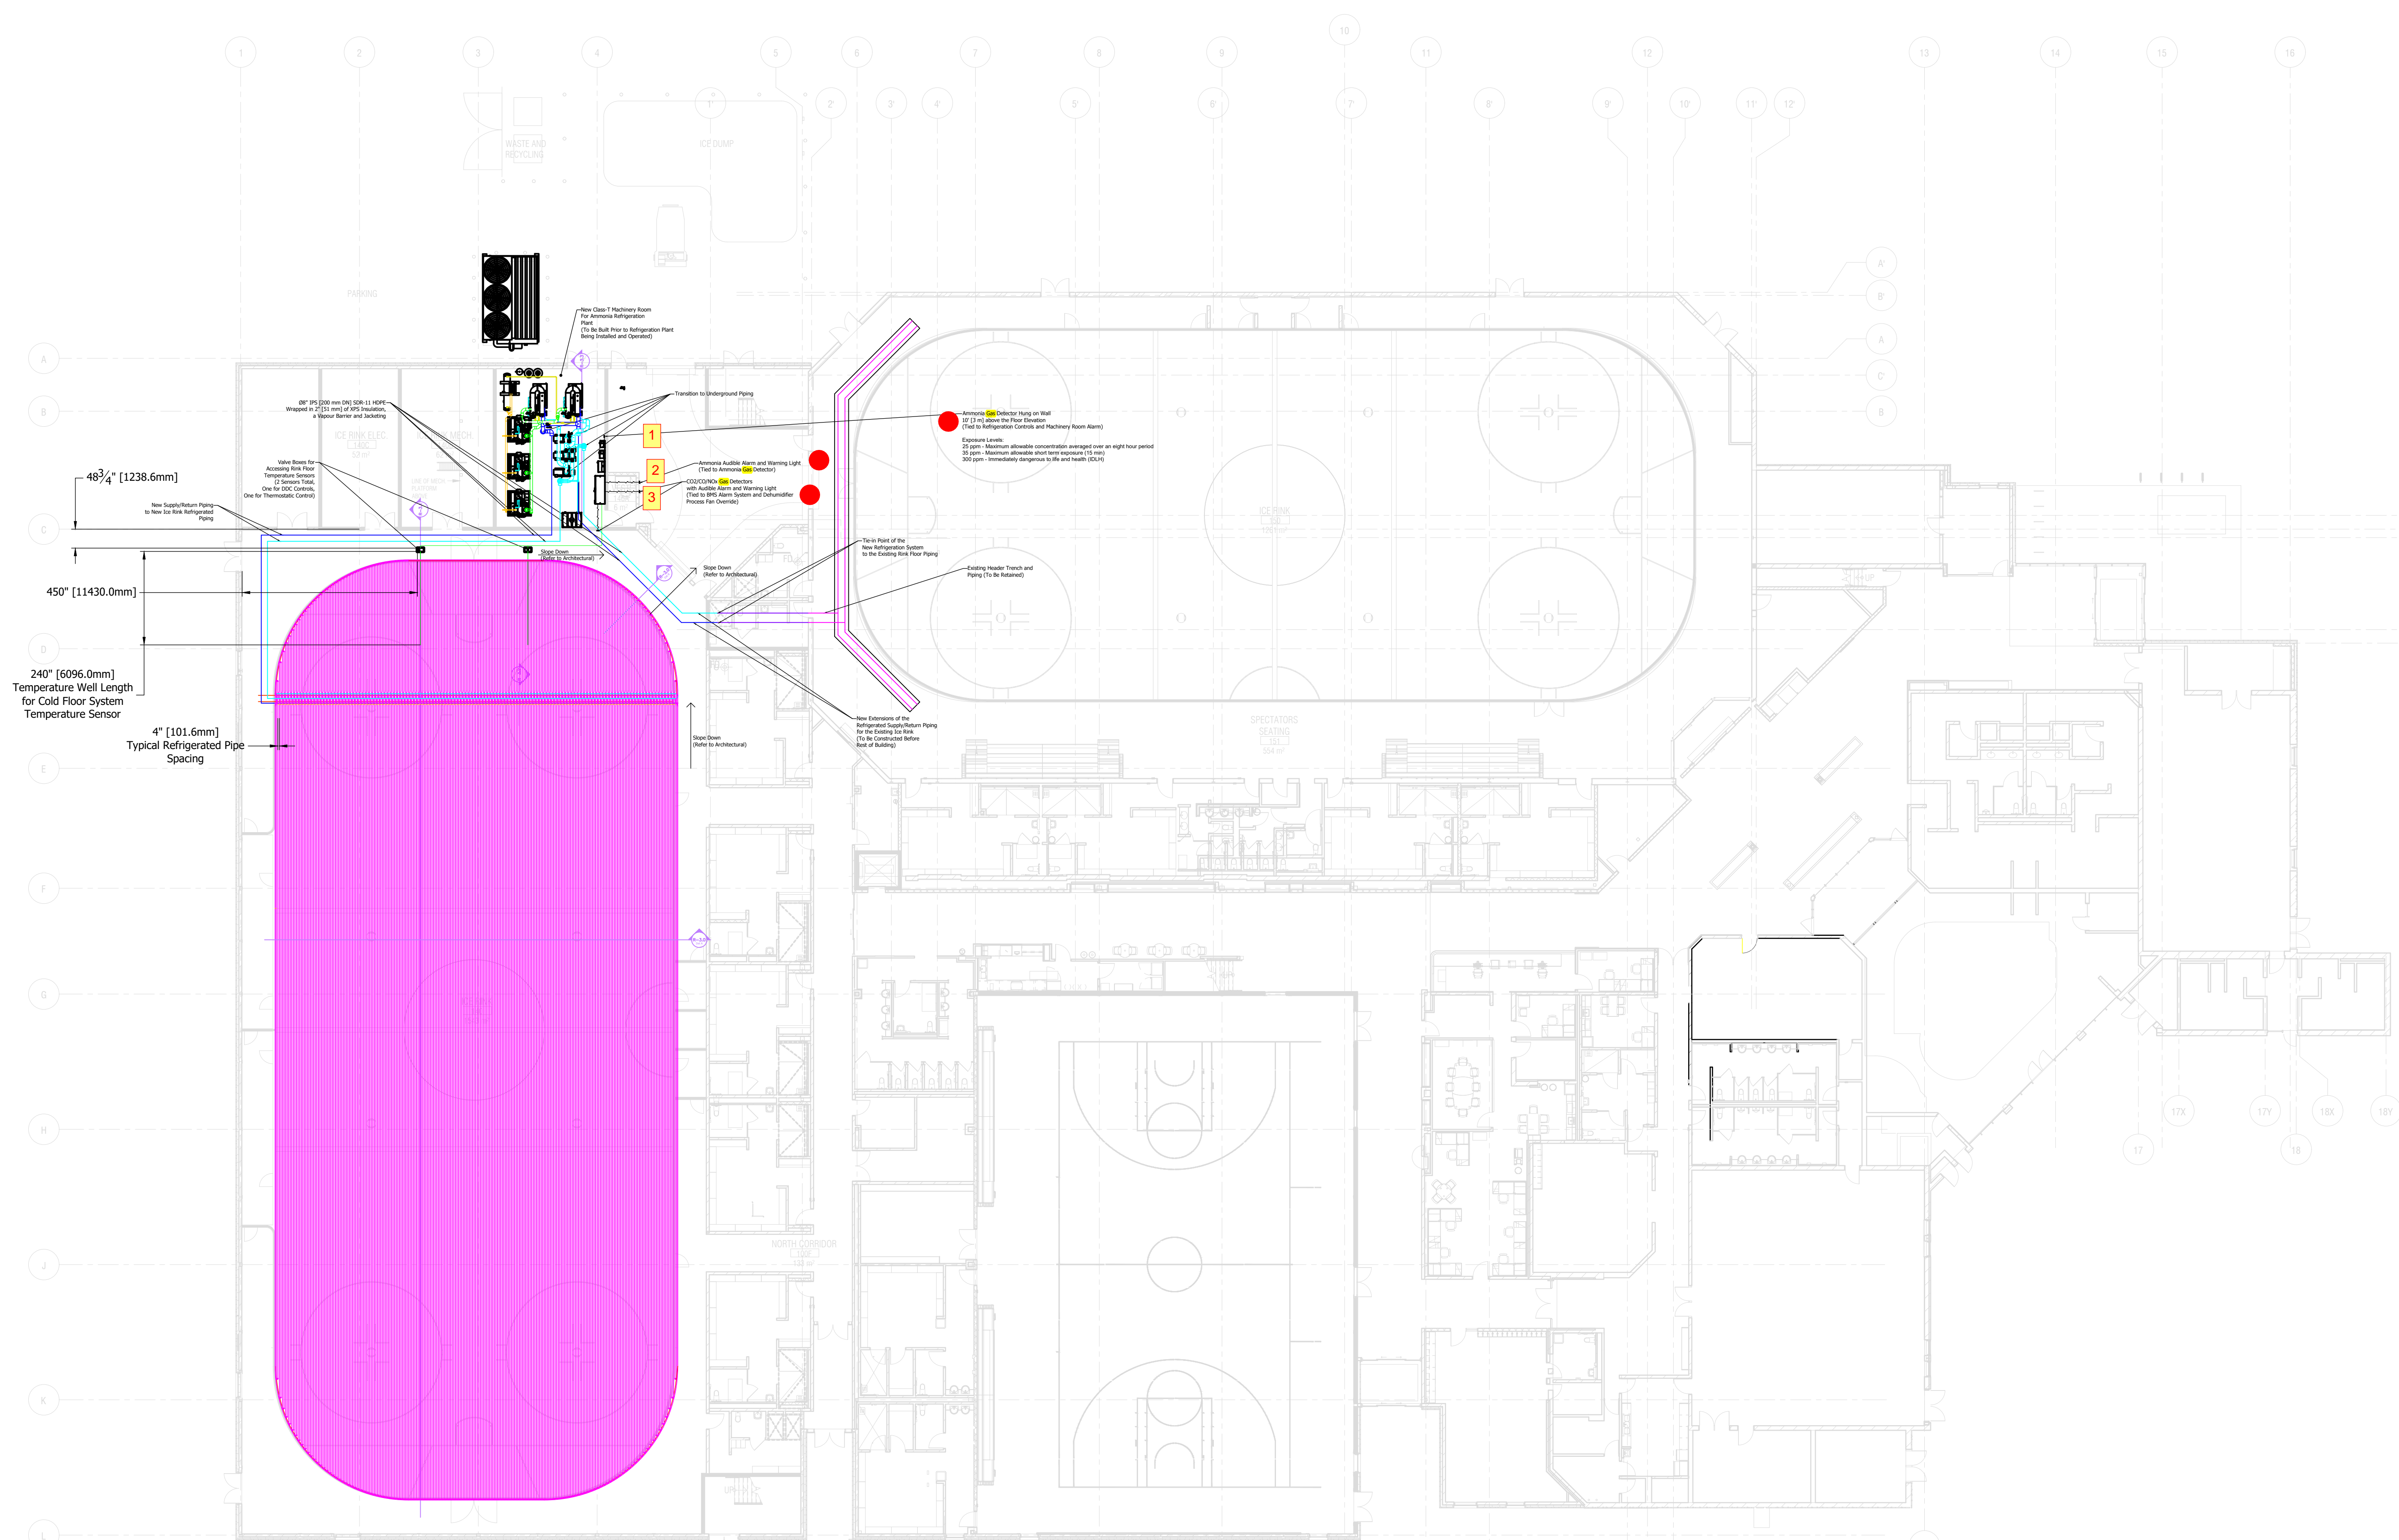

REF-01 & REF-02

BOM		
Qty	Part Number	Description
2	CS-650-R1	Current sensor, 0-5 Vdc, 0-10 / 20 / 50 amp, selectable

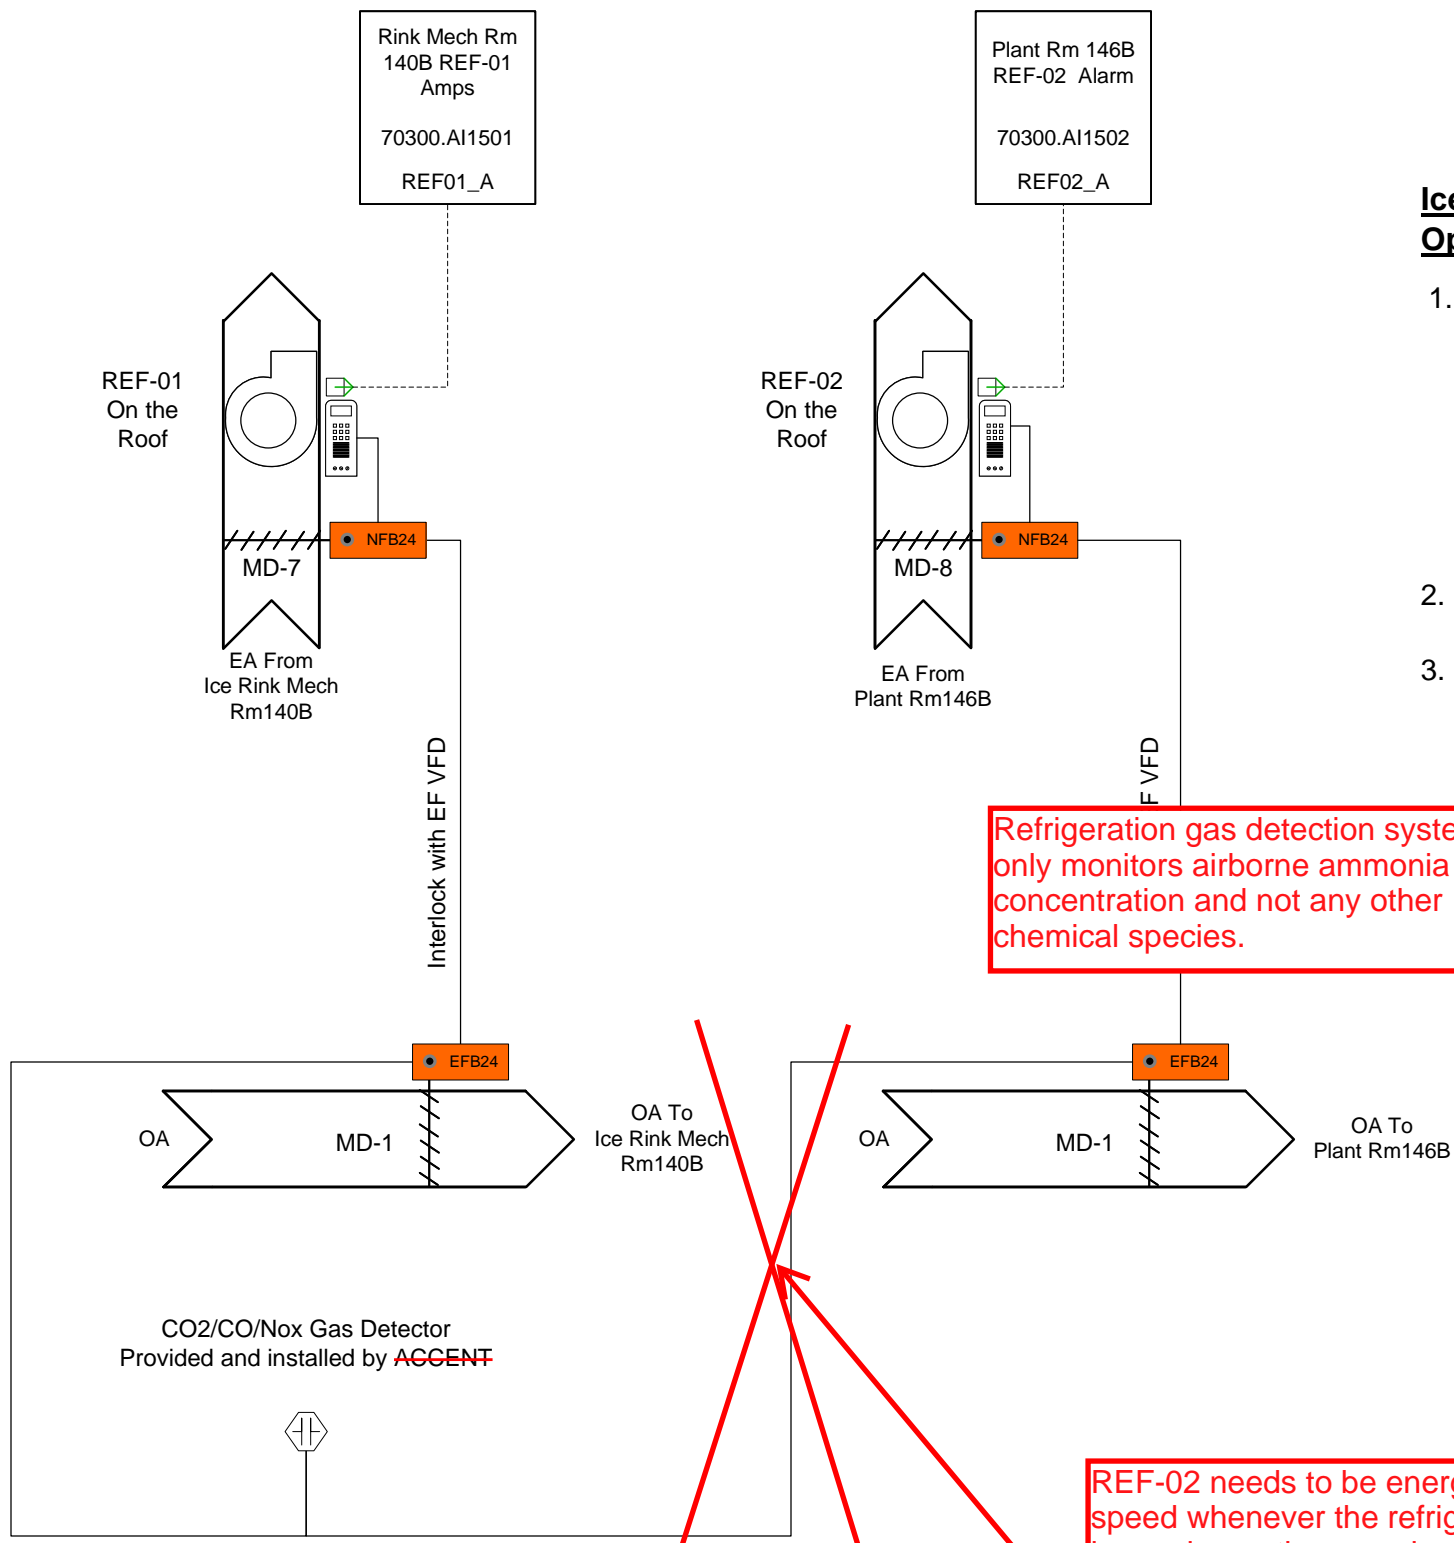

Ice Rink Mech Rm & Plant Rm Exhaust Fans - Sequence of Operations

- Run Conditions – REF01, REF02 and associated exhaust air damper and intake fresh air are hardwire interlocked by the refrigeration gas detection system provided and installed by ACCENT:
 - Exhaust fans shall energize by Gas detection system when,
 - ~~When low CO, low O2, low NO2 and low LEL alarms occur.~~
 - ~~When high CO, sub-normal O2, high NO2, and high LEL alarms occur.~~
 - ACCENT shall provide BAS details and coordinate onsite for above mentioned alarms.
- Fan Status:
 - The fan status is monitored by BAS.
- Alarms shall be provided as follows:
 - All alarms from Gas Detection system provided and installed by ACCENT

CIMCO

Refrigeration gas detection system only monitors airborne ammonia concentration and not any other chemical species.

Only REF-02 in the Plant room (146B) will have an interlock with the refrigeration gas detection system.

REF-02 needs to be energized at low speed whenever the refrigeration plant is running or the room is occupied (not by IAQ conditions). It is run at full speed whenever the airborne ammonia concentration exceeds 25 ppm.

Notes

1.

PROJECT

City of Brampton-Chris Gibson Rec Centre - Addition



5525 Eglinton Ave. West, Suite 100, Toronto, Ontario, M9C 5K5

DRAWING TITLE:

REF-01 & REF-02

PROJECT MANAGER Noel Santana	PROJECT DESIGNER Jingli An
PROJECT NO. P444D57	DATE Feb. 25, 2025
VERSION 1.1	DRAWING NO. DWG-47