



54 Audia Court, Unit 2
Concord, ON L4K 3N5
(905)-738-1400

Request For Information 25-000-001

Feb 13, 2025

Project Name	Project Address
Pod Inn Hotel-400 University -Mezzanine Reno	Pod-Inn Hotel Ltd 400 University Ave, Mezzanine Level Toronto, ON M5G 1S5
To	From
Name	Name
WALID ELSAYED	MOHAMMED LODHI
Company	Company
Walid Elsayed - Pod-Inn Hotel Ltd.	Consult Mechanical Inc.
Email	Email
elsayed.walid@gmail.com	mohammed.l@consultmechanical.com
Address	Address
289 Hollymount Dr. Mississauga, ON L5R 3X5	54 Audia Court, Unit 2 Concord, ON L4K 3N5

Title	SCHEDULE IMPACT	COST IMPACT
DUCT PROPOSAL DUE TO SITE CONSTRAINTS	No	No


RETURN BY

Feb 17, 2025


Information Requested

Kindly review attached drawing marked up with comments. The duct proposal is due to site constraints which require these changes. Please review and confirm at earliest so works can be proceeded with, thanks.

Proposed approach is accepted.
Walid Elsayed - Project Manager
13 Feb 2025

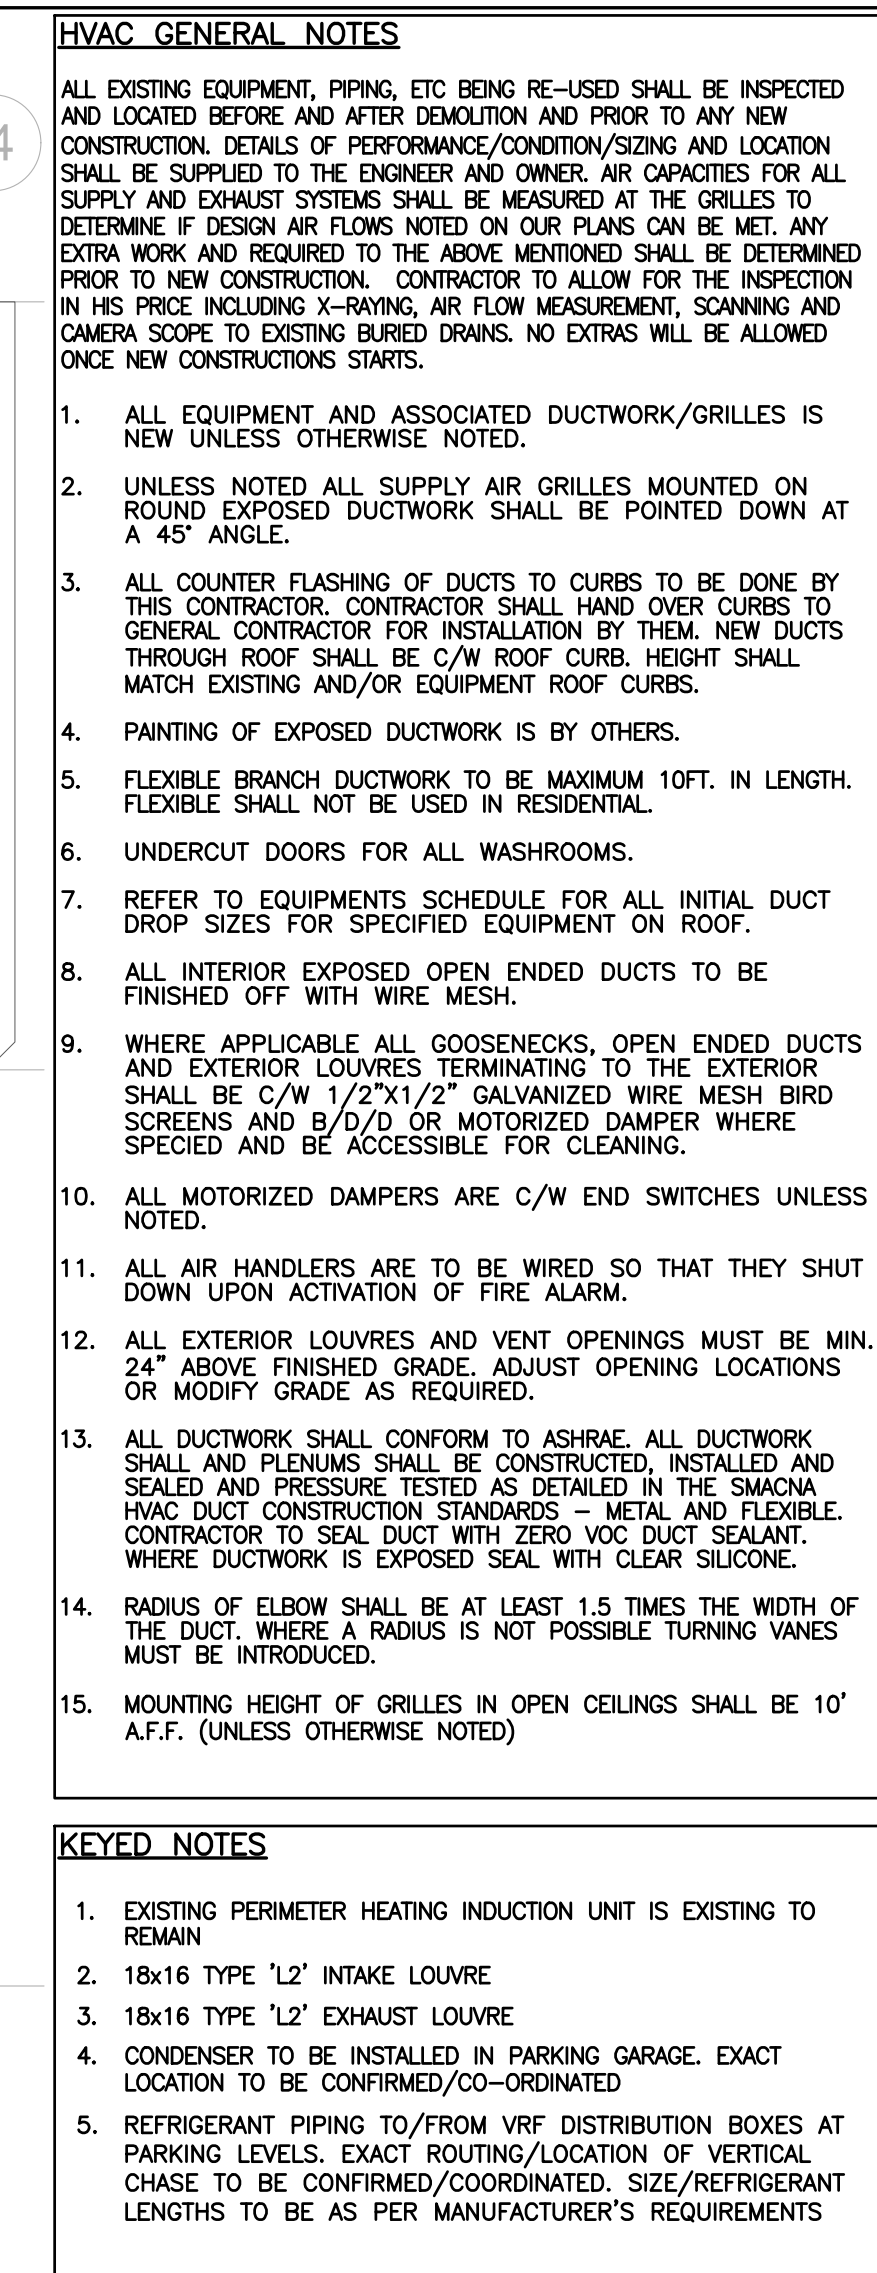

DUE TO AN EXISTING DUCT WE
ARE PROPOSING TO REROUTE
NEW DUCT AS SHOWN IN SKETCH
BELOW, PLEASE ADVISE IF OK TO
PROCEED

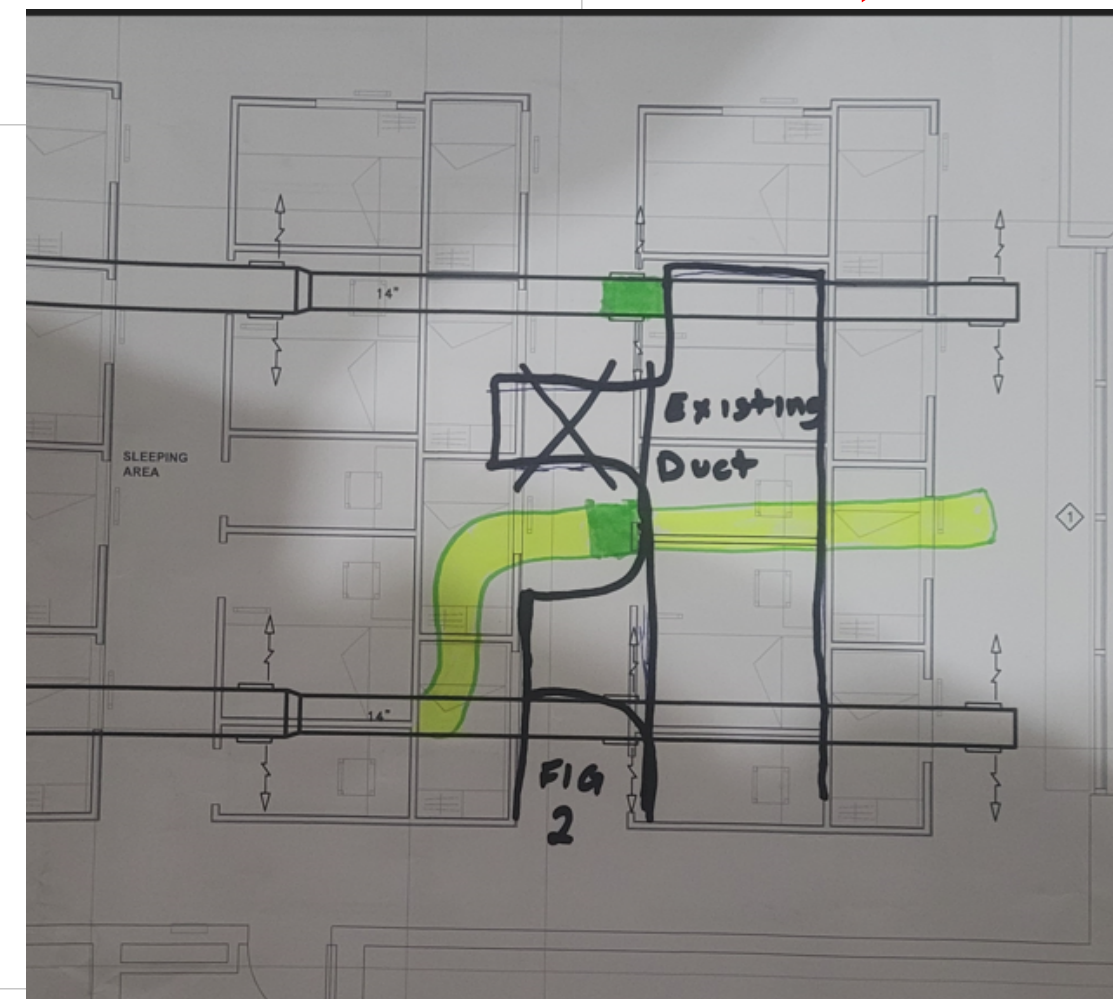


6	1/15/2025	ISSUED FOR PERMIT REVISIONS
5	1/7/2025	ISSUED FOR PERMIT
4	11/26/2024	ISSUED FOR TENDER
3	9/24/2024	ISSUED FOR PERMIT
2	9/19/2024	ISSUED FOR REVIEW
1	7/23/2024	ISSUED FOR PRELIMINARY EQUIP. LAYOUT

THIS DRAWING SHALL BE USED ONLY FOR THE PURPOSE INDICATED
IN THE LATEST ISSUED COLUMN ABOVE

ALL DRAWINGS AND SPECIFICATIONS ARE THE PROPERTY OF THE DESIGNER AND MAY NOT BE REPRODUCED WITHOUT WRITTEN PERMISSION. DRAWINGS MUST NOT BE SCALED. CONTRACTOR SHALL CHECK AND VERIFY ALL DIMENSIONS ON SITE AND REPORT ERRORS AND OMISSIONS TO THE DESIGNER. THIS DRAWING SHALL NOT BE USED FOR CONSTRUCTION UNLESS COUNTERSIGNED BY THE DESIGNER.

THESE DRAWINGS ARE NOT
TO BE SCALED.

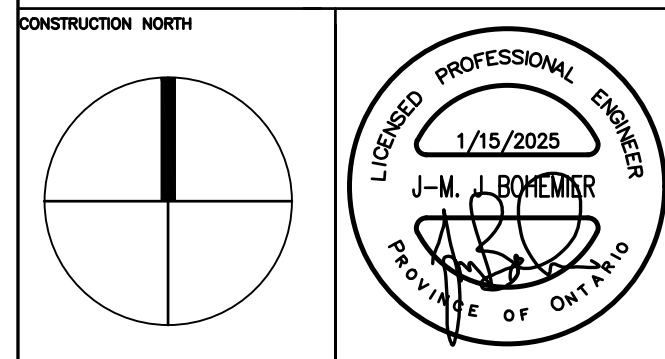

B K

CONSULTING INC.

23 - 1111 Davis Rd.
Newmarket, Ontario L3Y 9E5
T (905) 773-0200
staff@bkconsulting.ca

**POD INN HOTEL
400 UNIVERSITY**

TORONTO ONTARIO

MECHANICAL

PLOT DATE	PROJECT No. 24-711
-----------	-----------------------

DRAWING TITLE	
---------------	--

H/VAC LAYOUT

DATE	
------	--

2024	

DRAWN BY JW	M-1
----------------	-----

SCALE	
-------	--

M-1

OF 5