

8850 GEORGE BOLTON PARKWAY, CALEDON, ONTARIO L7E 2Y4

Request for Information#35

 Project Name:
 Construction of Victoria Park Arena and Brampton Sports Hall of Fame
 Contract No.:
 NRFP2024-232

 Customer Name
 City of Brampton
 Prepared By:
 Abdullah Hissamuddin

 Date Submitted:
 February 28, 2025
 Date Required:
 March 7, 2025

Total Pages: 1 of 1

Attachments: None

Description: Frost control clarification

Our frost control is actually included which is the thermostat (model CTH291) that will get mounted and wired to the 0-10vdc terminal block on the heater. They will set the temperature on the stat accordingly.

Please confirm this is approved/suitable.

Your prompt response to this RFI would be greatly appreciated.

Abdullah Hissamuddin

Rafat General Contracting Inc.

WSP-Mechanical:

This is accepted, thank you for the clarification.



Request For Information 24-280-001

Feb 27, 2025

Project Name Project Address

VICTORIA PARK ARENA 20 Victoria Crescent, Brampton, ON L6T 1E4

To From

Name Name

Abdullah Hissamuddin INZAMAN KHAN

Company Company

Consult Mechanical Inc. RAFAT GENERAL CONTRACTOR INC.

Email Email

abdullah.hissam@rafat.ca inzaman@consultmechanical.com

Address Address

8850 GEORGE BOLTON PKWY BOLTON, ON L7E 2Y4 54 Audia Court, Unit 2 Concord, ON L4K 3N5

Title SCHEDULE IMPACT COST IMPACT

Frost control clarification for Electric Duct Heaters Probable No EBC-1,2,3 (23 82 39)

RETURN BY Mar 4, 2025

Information Requested

In response to the engineer's comment regarding the justification on frost control in the reviewed submittal (attached). We want to clarify that the frost control is actually included which is the thermostat (model CTH291) that will get mounted and wired to the 0-10vdc terminal block on the heater. They will set the temperature on the stat accordingly.

Please confirm or advise if this is approved/suitable. If more specific control is required it'll need to be confirmed through a site instruction.

- CA AUTOMATIC CUT-OUT
- CN MANUAL CUT-OUT
- TO TRANSF.C/W FUSIBLE LINK
- P6 BUILT-IN AIR FLOW SENSOR
- IC INTERLOCK TERMINAL STRIP
- B1 S.C.R. BY THERMOLEC
- AA STAT 0-10VDC (CTH291) + DS600 X6 DOOR INTERLOCK DISC. SWITCH
- SC SLIP-IN OPEN COIL DUCT HEATER



8850 GEORGE BOLTON PARKWAY, CALEDON, ONTARIO L7E 2Y4

Shop Drawings	23 82 39-01R0
Transmittal No:	20 02 03 01110

Project Name:	Construction of Victoria Park Arena and Brampton Sports Hall	Project No.	NRFP2024-232		
	of Fame	DATE:	06 Feb 2025		
		Submittal Required	20 Feb 2025		
-		Return Date:			
Submittal No:	27				
Title:	SD-Electric Duct Heaters EBC-1-3				
To:					
	Mark Falkenburger				
Checked by:	Abdullah Hissamuddin	To Be Reviewed By the Following Consutlants	Architecture49 & WSP		
		•			
Submitted for:	Review and Approval				
Consultants Response	e				

wsp										
REVIEWED	BY Jerry Nweisser									
I <u> </u>	DIVISION Buildings - Sustainability									
REVIEWED AS NOTED	DATE 2/20/2025									
REVISE & RESUBMIT	SUBMITTAL# 21-03									
PROJECT CA-WSP-221-05263-00										
	VING DOES NOT IN ANY WAY CONTRACTOR OF RESPONSIBILITY R COMPLIANCE WITH THE									





SHOP DRAWING REVIEW

Project Name: Victoria Park Arena Project No. CA-WSP-221-05263-00

Date 2025-02-19

Received:

Shop Drawing: Title: Electric Duct Heaters

Revision: 00 Submission No.: 21-03

This review by consultant is for sole purpose of ascertaining conformance with general design concept. This review does not mean that consultant approves detail design inherent in shop drawings, responsibility for which remains with contractor, and such review does not relieve contractor of responsibility for errors or omissions in shop drawings or of contractor's responsibility for meeting all requirements of contract documents. Be responsible for dimensions to be confirmed and correlated at job site, for information that pertains solely to fabrication process or to techniques of construction and installation, and for coordination of the work of subtrades.

	Reviev	ved	Mechanical Rev	view Required	Electrical Review Required						
□ R	Reviev	wed as Noted	Reviewed by:	Jerry Nweisser	Reviewed by:	Brad Li					
⊠ R	Revise	e & Resubmit	Review Date:	2025-02-19	Review Date:	2025-02-20					
Iten	n	Comments									
1.		Contractor to include the required control component for frost control. Submittal shows that this has been excluded, please provide justification for exclusion.									
		Elec review comments below (Reviewed as noted)									
2.		The tags for EBCs units on Elec drawings were shown as ECB, but it was the same unit as EBC as per Mech schedule and layout, and the tags on Elec drawings should have been corrected to EBC, contractor could correct the typo of the EBC unit on Elec as-built drawings set.									

End of Review



Submittal 24-280-001

PROJECT NAME PROJECT ADDRESS DATE SUBMITTED

VICTORIA PARK ARENA 24-280 20 Victoria Crescent, Brampton, ON L6T 1E4 Feb 3, 2025

TO FROM

Abdullah Hissamuddin INZAMAN KHAN

COMPANY

RAFAT GENERAL CONTRACTOR INC. Consult Mechanical Inc.

EMAIL

abdullah.hissam@rafat.ca inzaman@consultmechanical.com

ADDRESS ADDRESS

8850 GEORGE BOLTON PKWY BOLTON, ON L7E 2Y4 54 Audia Court, Unit 2

Concord, ON L4K 3N5

Title

Electric Duct Heaters EBC-1-3 (23 82 39)

Description

- EBC-1 1kW 120V/1PH
- EBC-2 3.4kW 120V/1PH
- EBC-3 2kW 120V/1PH
- Frost control not included
- Lead: 6-8 weeks

Package Items



Submittal #85160

APPROVAL REQUIRED

Project 22104386-MECH-1- Brampton Victoria Park Arena

Leader Nevin Wong

Job Site Brampton Victoria Park Arena

Submission Date2025-02-03Sold ToCONSULT MECHSubmitted ByChantal Koudou

Contacts

Role	Customer	Contact	Our Rep
Mechanical Contractor	Con-Sult Mechanical Inc.*	Inzaman Khan	Nevin Wong
General Contractor	Rafat General Contracing Inc		
Mechanical Contractor	Con-Sult Mechanical Inc.*	Mohammed Ali Khan Lodhi	Nevin Wong
Mechanical Contractor	Con-Sult Mechanical Inc.*	Paul Leddy	Nevin Wong
Designer	WSP MMM Group	·	Alex Forsea

Deliverables

Track #	289037	
Tag	EBC-1-3	
Description	Electric Duct Heaters	
Quantity	3	
Production Lead Time		
Revision #	0	

Notes:

C/w:

- EBC-1 1kW 120V/1PH
- EBC-2 3.4kW 120V/1PH
- EBC-3 2kW 120V/1PH
- Frost control not included

Attention:

- 1) HTS will provide equipment in accordance with the attached shop drawings.
- 2) Upon approved submittal and customer release, HTS will release equipment to fabrication per the published lead times. Any storage fees associated with project schedule changes will be the responsibility of the purchaser.
- 3) HTS can provide freight and logistics to the purchaser as an added benefit of doing business with HTS. When freight is received by the purchaser, any noticeable damage must be recorded. Otherwise, HTS is not responsible for subsequent damage claims.

_		

Electric duct heater shop drawings

	SCHEDULE OF ELECTRIC BOOSTER COIL												
TAG	TAG AREA SERVED TYPE AIRLFOW (L/S) CAPACITY (KW) DUCT INLET SIZE (A.T. (°C) L.A.T. (°C) ELECTRICAL V/Φ/Hz												
EBC-1	ERV-2	ELECTRIC	40	1.0	150x150	-21.0	-1.0	120/1/60	1				
EBC-2	ERV-3	ELECTRIC	140	3.4	250x250	-21.0	-1.0	120/1/60	1				
EBC-3	ERV-4	ELECTRIC	80	2.0	200x200	-21.0	-1.0	120/1/60	1				

NOTES:

 $oxed{1}$. C/W THE REQUIRED CONTROL COMPONENT FOR FROST CONTROL. CONNECT TO ERV CONTROLLER.

2060, LUCIEN-THIMENS STREET, ST-LAURENT, QUÉBEC, CANADA H4R 1L1
TEL.: 514-336-9130 FAX: 514-336-3270

TM

IMPERIAL SYSTEM

COPIES:

X METRIC SYSTEM CSA - NRTL/C APPROVED # LR-30551 APPROVAL DRAWINGS

HTS ENGINEERING LTD.

CUSTOMER NAME : CONSULTING ENG. :

DATE

PROJECT : CONTRACTOR :

BRAMPTON VICTORIA PARK AREN

P.O. NUMBER

QUOTE#

PAGE

OUOTE

863608

	ELECTRIC	CAL HEA	TER			SEE A	DIME TTACHED N	NSION:	S L DRAWIN	G		ELECTRICAL DATA				BUILT-IN CONTROLS
ITEM	TAG	TAG QUANTITY W		W H D		KW	KW VOLT / PH AMPS		ST / KW		OPTIONS					
MECH	IANICAL DI	RAWING	; #		TYPE	T	•	Х		С	ELECTRICAL	DRAWING #	CFM · I/s	FPM · m/s	CONTR VOLTS	SYMBOLS ARE EXPLAINED BELOW
	EBC-1)-10LS-	1002-	-0000	1	SC	152	254	152	457	127 127	1.00 1B10-DS10	120/1 J-1000-0000	8.33 40	1/ 1.73		CACNT0P6ICB1AAX6SC
	EBC-2)-10LS-	1002-	-0000	1	SC	250	356	250	356	127 127	3.40 1B10-DS10	120/1 J-H000-0000		1/ 2.24		CACNT0P6ICB1AAX6SC
	EBC-3)-10LS-	1002-	-0000	1	SC	200	254	200	457	127 127		120/1 J-1000-0000		1/ 2.00		CACNTOP6ICB1AAX6SC
4 S S M M NO					200000000000000000000000000000000000000											

REMARKS:

FROST CONTROL NOT INCLUDED

CA AUTOMATIC CUT-OUT

CN MANUAL CUT-OUT

TO TRANSF.C/W FUSIBLE LINK

P6 BUILT-IN AIR FLOW SENSOR

IC INTERLOCK TERMINAL STRIP

B1 S.C.R. BY THERMOLEC


DI D.C.II. DI IIIDIGIOLIO

AA STAT 0-10VDC (CTH291) + DS600

X6 DOOR INTERLOCK DISC. SWITCH

SC SLIP-IN OPEN COIL DUCT HEATER

mturriff@thermolec.ca

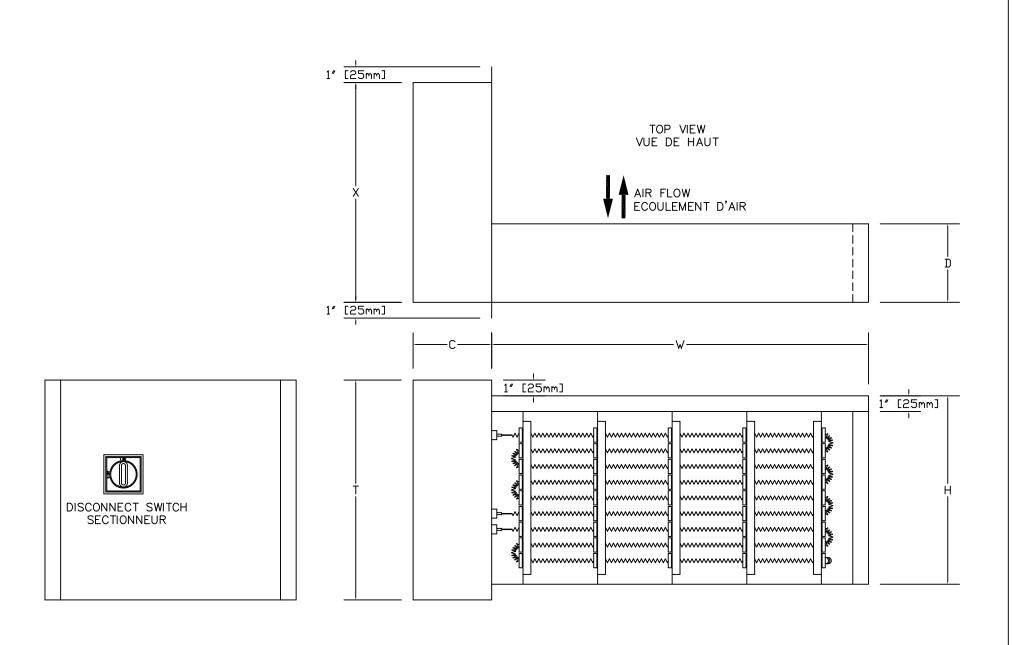


TITLE/TITRE

TYPICAL SLIP-IN TYPE HEATER
SERPENTIN A INSERTION TYPIQUE



LTEE LTD DRAWING NO. MSCO-10LS-1002-0000

DATE PER

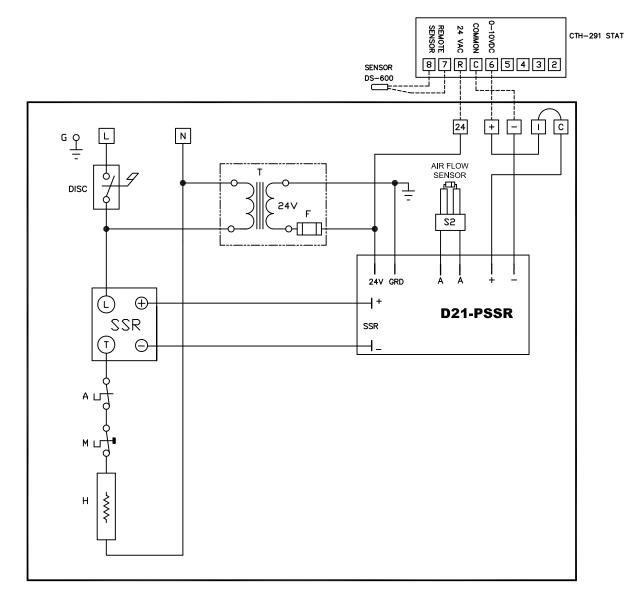

LEGENDE

A Sonde Thermique à Réenclenchement

Automatique

M Sonde Thermique à Réenclenchement

Manuel

D21-PSSR Contrôleur Electronique

DISC Sectionneur F Fusible

SSR Relais Electronique

T Transformateur

S2 Détecteur de Débit d'air

LEGEND

A Automatic Reset Cut Out
M Manual Reset Cut Out
D21-PSSR Solid State Controller
DISC Disconnect Switch
F Fuse Or Fuse Link
SSR Solid State Relay

T Control Circuit Transformer

S2 Air Flow Sensor

IMPORTANT

Enlever le pont entre les bornes "l" & "C" avant de connecter l'entrebarrage, si applicable.

Suivre les codes électriques nationaux et locaux ainsi que les instructions contenues dans l'appareil.

Le serpentin électrique Thermolec est representé par un cadre en gros traits. Tout ce qui est en dehors du cadre est un "filage typique externe fait par d'autres".

IMPORTANT

Remove the jumper between "I" & "C" before connecting interlocks, if applicable.

Wire in accordance with Local Electrical codes. Read instructions carefully before wiring and operating.


Frame shown in heavy line represents Thermolec Electric Coil. All wiring outside this frame are "typical external wiring by others".



Title / Titre

Drawing number / Numéro de dessin

1B10 - DS1U - 1000 - 0000

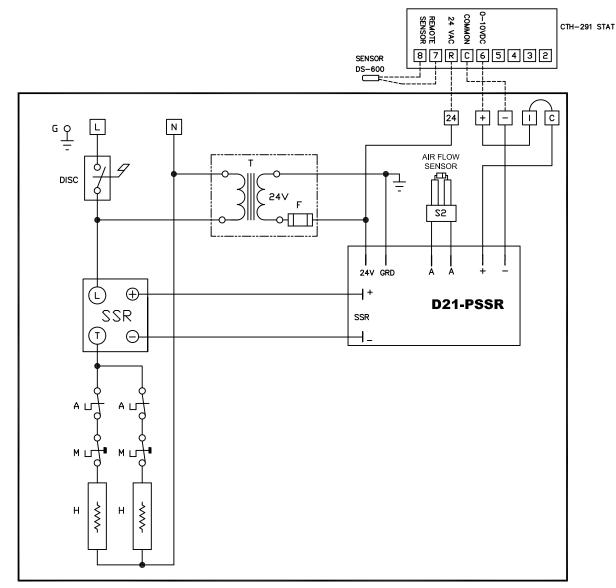

LEGENDE

A Sonde Thermique à Réenclenchement

Automatique

M Sonde Thermique à Réenclenchement

Manuel

D21-PSSR Contrôleur Electronique

DISC Sectionneur F Fusible

SSR Relais Electronique

T Transformateur

S2 Détecteur de Débit d'air

LEGEND

A Automatic Reset Cut Out
M Manual Reset Cut Out
D21-PSSR Solid State Controller
DISC Disconnect Switch
F Fuse Or Fuse Link
SSR Solid State Relay

T Control Circuit Transformer S2 Air Flow Sensor

IMPORTANT

Enlever le pont entre les bornes "l" & "C" avant de connecter l'entrebarrage, si applicable.

Suivre les codes électriques nationaux et locaux ainsi que les instructions contenues dans l'appareil.

Le serpentin électrique Thermolec est representé par un cadre en gros traits. Tout ce qui est en dehors du cadre est un "filage typique externe fait par d'autres". **IMPORTANT**

Remove the jumper between "I" & "C" before connecting interlocks, if applicable.

Wire in accordance with Local Electrical codes. Read instructions carefully before wiring and operating.

Frame shown in heavy line represents Thermolec Electric Coil. All wiring outside this frame are "typical external wiring by others".



Title / Titre

Drawing number / Numéro de dessin

1B10 - DS1U - H000 - 0000