



REQUEST FOR INFORMATION

Date: January 15, 2025

Trisect Project No: TC24-114

Project Name: York Region Admin., Package D Renovation

CONSULTANTS RFI NO: TC24-114-15-X

To: Stephanie Kamburis @ G. Bruce Stratton Architects cc: Victor Chau @ York Region cc: Natalie Freitas @ York Region From: Tom Butkovic, Ivan Lulic, Jay Cowie	REFERENCE: Ground Floor Duct Size Spec. Section: Drawing No.(s): Attachments:
--	--

Interior Design ☐ Architectural ☐ Structural ☐ Mechanical ☒ Electrical ☐

RESPONSE/INFORMATION REQUIRED BY: [Jan. 17, 2025](#)

Please find the following RFI sent from our Mechanical subcontractor:





54 Audia Court, Unit 2
Concord, ON L4K 3N5
(905)-738-1400

Request For Information 24-277-005

Jan 10, 2025

Project Name

YORK REGION VARIOUS PROJECTS

Project Address

17250 Young Street Newmarket, ON

To

Name

Tom Butkovic

Company

TRISECT CONSTRUCTION

Email

tbutkovic@trisectionconstruction.com

Address

4020A SLADEVIEW cRESCENT, UNIT 7 MISSISSAUGA,
ON L5L 6B1 JOB: 1300 INSLINGTON SUITE 103

From

Name

PAUL LEDDY

Company

Consult Mechanical Inc.

Email

paul.l@consultmechanical.com

Address

54 Audia Court, Unit 2 Concord, ON L4K 3N5

Title

Ground Floor Block D Duct Sizing

SCHEDULE IMPACT

No

COST IMPACT

Probable


RETURN BY

Jan 10, 2025

Information Requested

16" round will not fit due to site conditions and height restrictions
See attached Drawing

GPY Response: The proposed two main runs of fresh air duct are acceptable. Contractor to ensure ducts are sized to deliver the required fresh air noted on the drawings. Contractor to ensure all changes/ revisions that deviates from the IFC set shall be reflected on the As-built drawings.

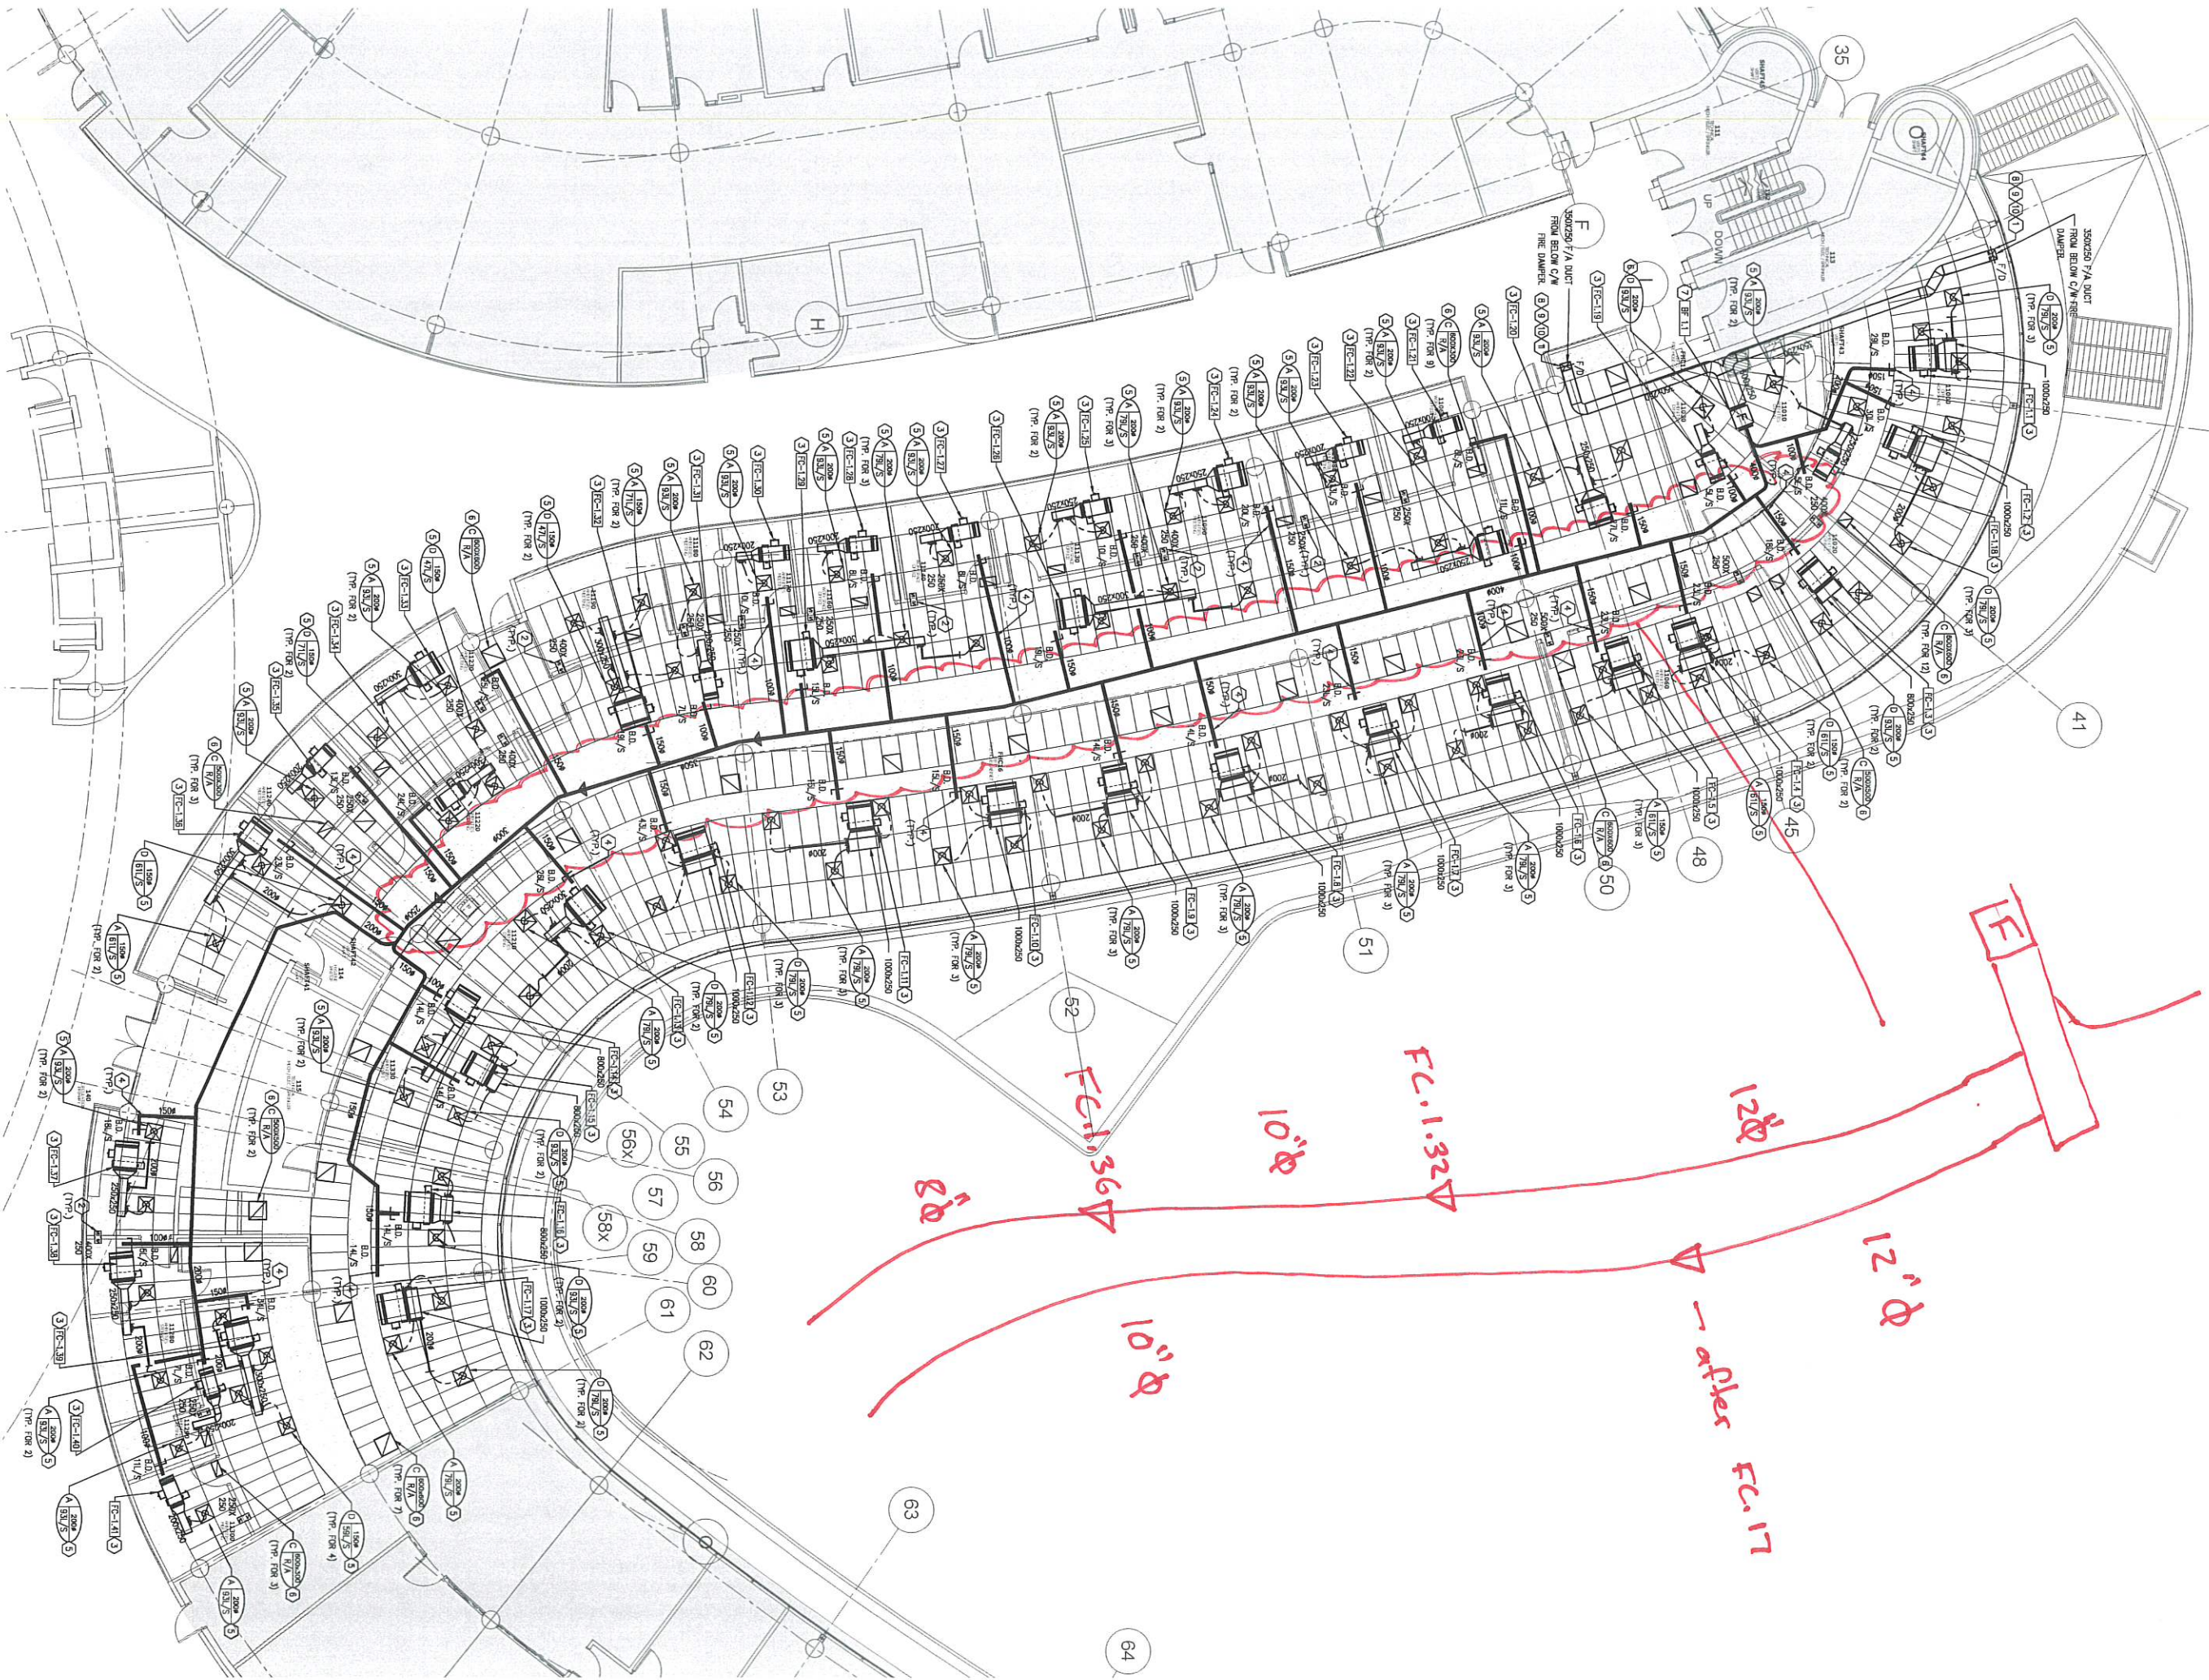

E

12"Ø

12"Ø

after

FC.17

FC.1.32

10"Ø

FC.1.36

8"Ø

10"Ø