

REQUEST FOR INFORMATION

Date: March 13, 2025

Trisect Project No: TC24-114

Project Name: York Region Admin., Package D Renovation

CONSULTANTS RFI NO: TC24-114-36-X

To: Stephanie Kamburis @ G. Bruce Stratton Architects

cc: Victor Chau @ York Region

cc: Natalie Freitas @ York Region

From: Tom Butkovic, Ivan Lulic, Jay Cowie

REFERENCE: Fan Coils Not Fitting

Spec. Section:

Drawing No.(s):

Attachments:

Interior Design ☐ Architectural ☐ Structural ☐ Mechanical ☒ Electrical ☐

RESPONSE/INFORMATION REQUIRED BY: March 17, 2025

On behalf of the Mechanical subcontractor, please review and reply to the following RFI:


Information Requested

There are 3 Fan Coil units that do not Fit in the rooms where they are shown

See the attached Mark up

It appears the Architectural drawings are not accurate and the walls in this area are not where they are shown on the drawings

Please advise

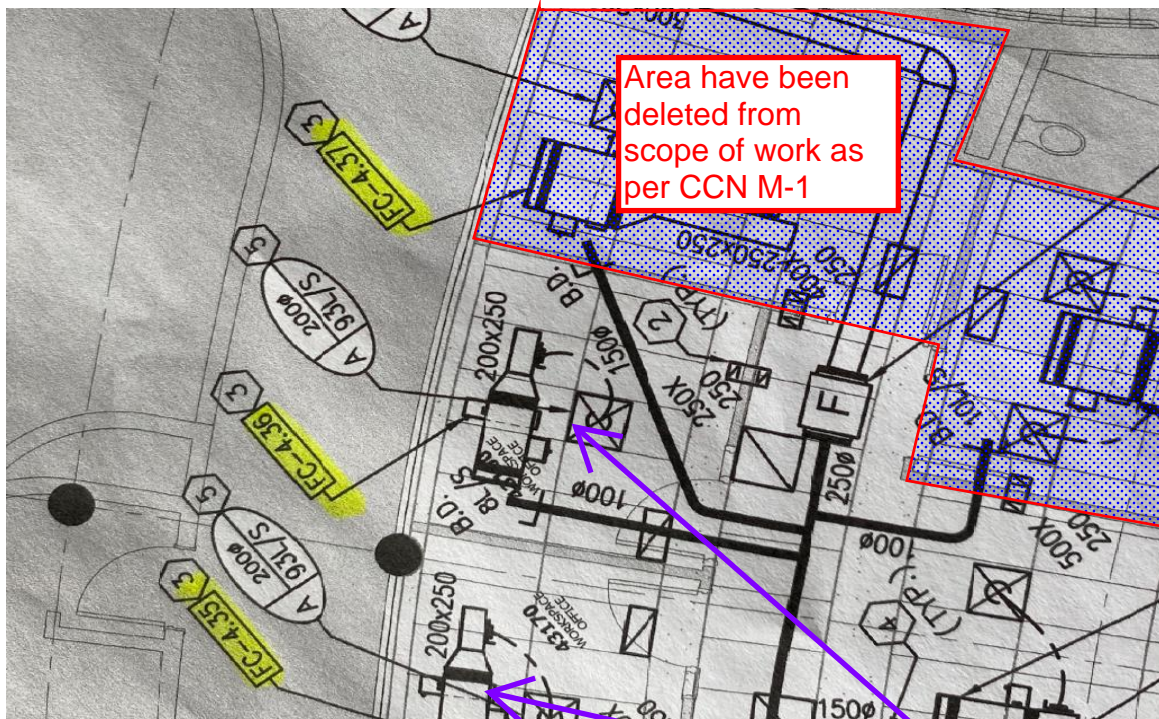

7-4020A Sladeview Crescent, Mississauga, ON L5L 6B1
p: 905-607-9600 f: 905-607-7757

Please adjust/shift
FCU's location to fit
within the room